


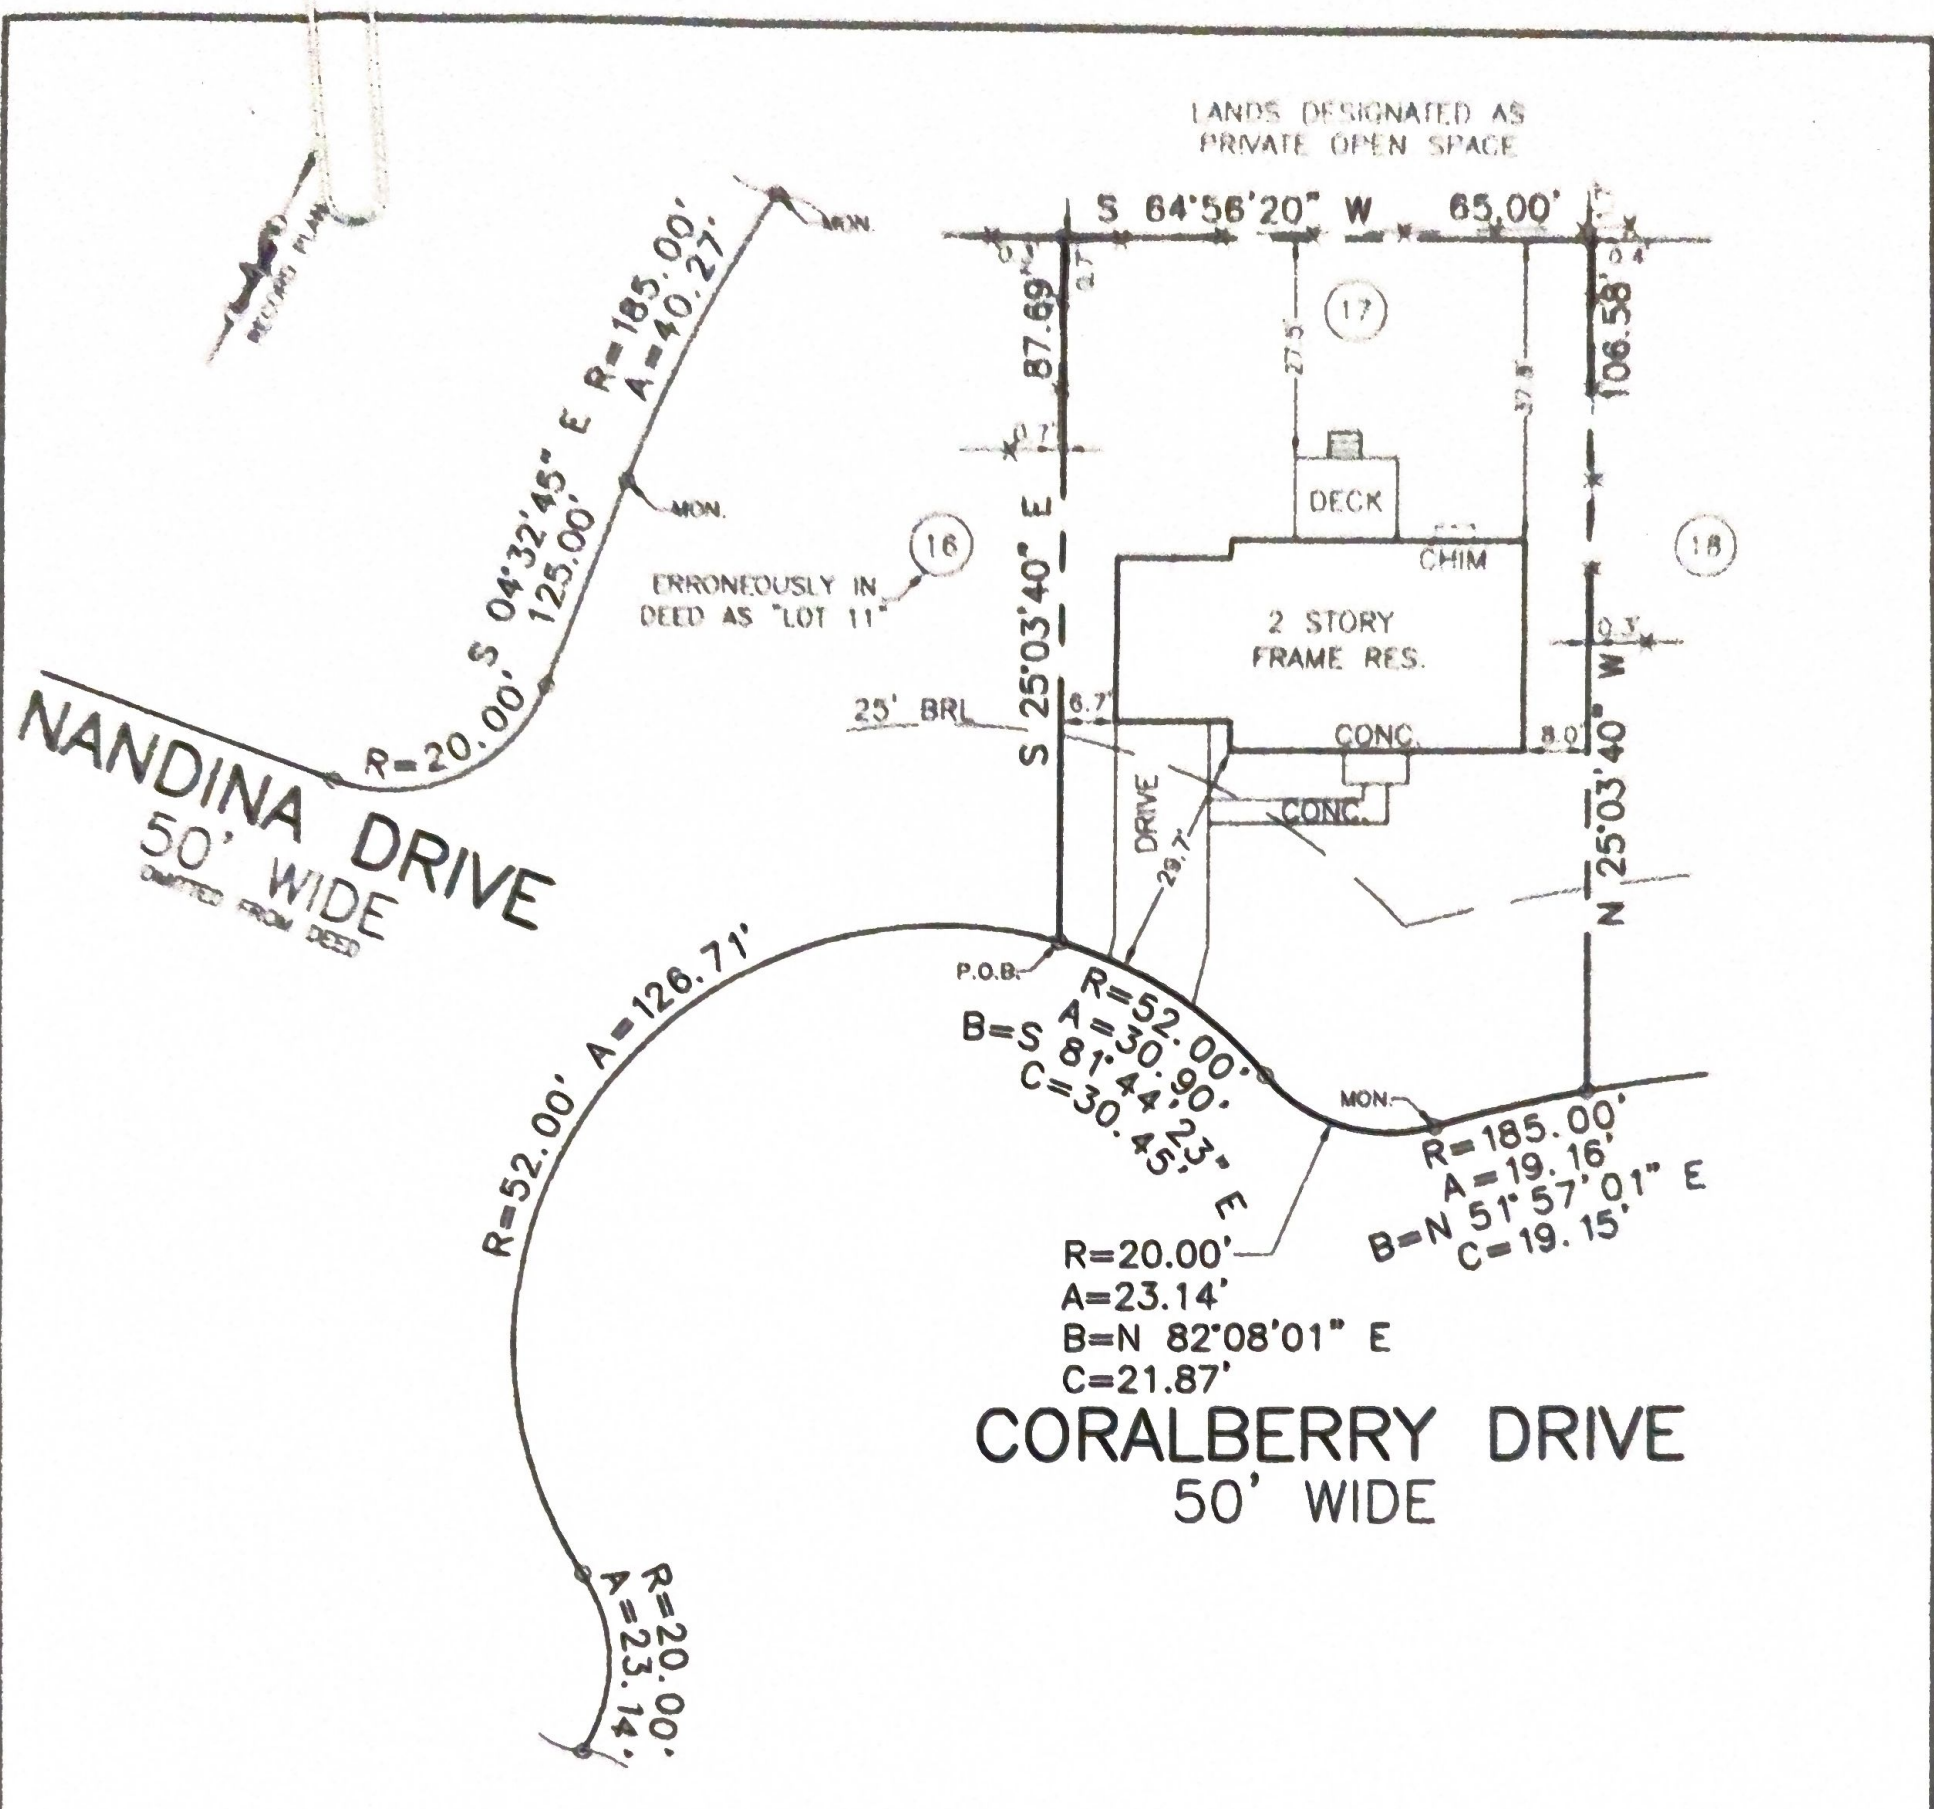

I HEREBY DECLARE THAT THE VISUAL IMPROVEMENTS SHOWN HEREON HAVE BEEN LOCATED. THIS PLAN IS INTENDED FOR THE USE OF THE PARTIES INVOLVED WITH THIS LAND TRANSACTION & SHALL NOT BE REPRODUCED OR USED FOR ANY OTHER PURPOSE, INCLUDING FUTURE IMPROVEMENTS AND DETERMINING PROPERTY LINES. TREES, LANDSCAPING & OTHER FEATURES HAVE NOT BEEN LOCATED UNLESS SHOWN HEREON. PROPERTY IS SUBJECT TO ANY AND ALL RESTRICTIONS AND EASEMENTS OF RECORD. THE ZONING CLASSIFICATION SHOWN HEREON REPRESENTS CURRENT ZONING AS OF THE DATE OF THIS PLAN. THE MINIMUM REQUIREMENTS ARE FROM THE ZONING CODE. ANY RESTRICTION LINES SHOWN ABOVE ARE FROM THE RECORD PLAN OR DEED RESTRICTIONS PROVIDED TO A.E.S. SURVEYORS. ANY VARIANCES, AGREEMENTS OR PRIOR ZONING ARE NOT KNOWN UNLESS SHOWN HEREON. IN ACCORDANCE TO THE DELAWARE BOARD OF PROFESSIONAL LAND SURVEYORS REGULATION 12.7; A WAIVER NOT TO SET CORNERS HAS BEEN OBTAINED. IF THIS DRAWING DOES NOT CONTAIN AN ORIGINAL RAISED IMPRESSION SEAL IT IS NOT IN COMPLIANCE WITH REGULATIONS AND CAN ONLY BE USED FOR REVIEW PURPOSES.

PROPERTY TO BE CONVEYED TO: RAUL ASTUDILLO MARKOCH & GEOMARA VARELA CHAPA		ZONED: NC6.5 SETBACKS: FRONT-25' REAR-25' SIDE-6'	
MORTGAGE SURVEY PLAN 9 CORALBERRY DRIVE LOT 17 - BLOCK A PERCH CREEK PENCADER HUNDRED NEW CASTLE COUNTY - DELAWARE TAX PARCEL # 11-026.30-185		AMERICAN EASTCOAST SURVEYING & MAPPING 3913 OLD CAPITOL TRAIL WILMINGTON, DE. 19808 PHONE: 302-993-1059 EMAIL: OFFICE@AESURVEYORS.COM	
DEED REF: 20220504-0047976		SCALE: 1"=30'	DATE: 4/14/26
PLAT REF: MF#11730		JOB # 20260590	CLASS S SURVEY

[Signature]